

1 2 3 4 5 6 7 8

A


A

B


B

C

C

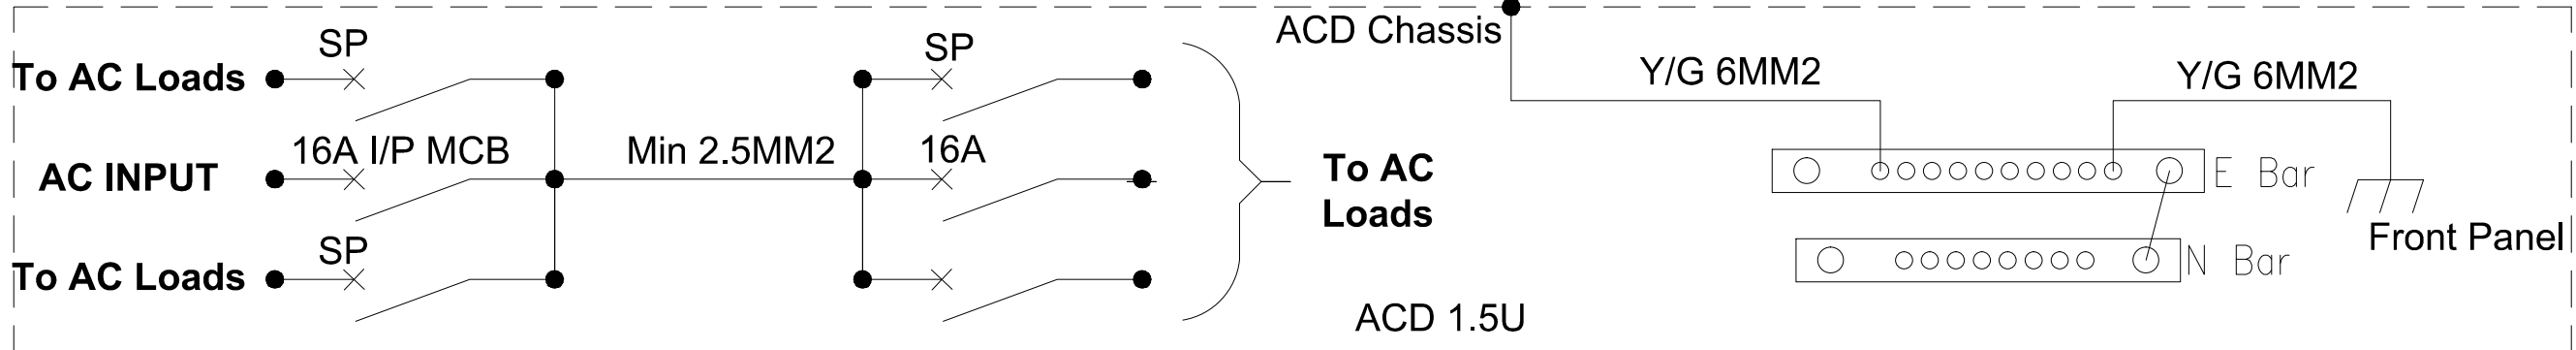

PRINT OUT LABELS AND PUT THEM ON FRONT PANEL

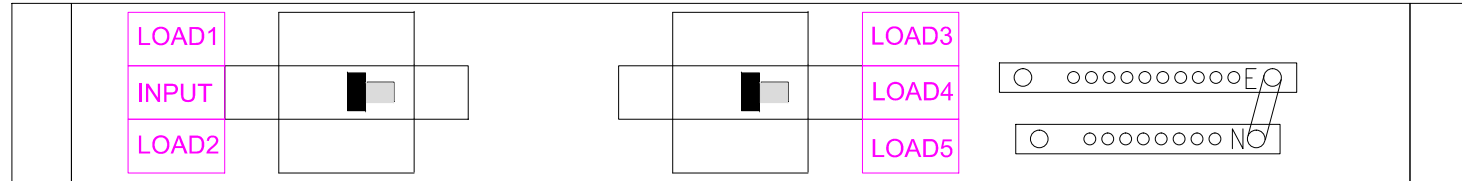

ACD15M-00

F

F

						DO NOT SCALE		DRAWN: SWU		EATON		EATON INDUSTRY COMPANY		Layout and Wiring Diagram (MTR16104)	
						ALL DIMENSIONS ARE IN MILLIMETERS (mm)		DATE: 7-10-2015		© 2015		106 WRIGHTS ROAD		of	
						GENERAL TOLERANCE		CHECK: Paul G		NEW ZEALAND		ADDINGTON, CHCH		ACD15M-00	
						UNLESS OTHERWISE STATED		APPR: Paul G		SCALE: N.T.S.		FINISH: N/A		DWG No: NZWD-000092	
001		ISSUED AS BUILT		-		7-10-2015		SWU		MAT: N/A		EATON P/N: NA		SHEET: 1 OF 2	
REV		CHANGE		ECO No		DATE		BY		SCALE: N.T.S.		EATON P/N: NA		A3	

1 2 3 4 5 6 7 8